

1026-05-04 CTNY26039 VILLAGE AT SHELLY CREEK.dwg


REFERENCE	PARENT	SUB
ROADS		
WATER		
SANITARY		
DRAINAGE		

	Existing Edge of Asphalt
	Existing edge of Gravel
	Existing Fence
	Existing Top of Slope
	Existing Hedge/Treeline
	Existing Deciduous/Coniferous/Shrub
	Prop./Existing Watermain
	Prop./Existing Water Service
	Prop./Adjusted/Existing Water Valve
	Prop./Existing Fire Hydrant
	Prop./Existing Water Sandstone
	Prop./Existing Curb Stop
	Prop./Existing End Cap

[illegible]

NO	DATE	DESCRIPTION	BY	APPROVED
1	03/02/2026	LOCATE WATER VALVES AND SURVEY	POI	
2	03/02/2026	LOCATE WATER VALVES AND SURVEY	POI	
3	04/02/2026	LOCATE WATER VALVES AND SURVEY		

DESIGN	
DATE:	
DRAWN:	
DATE:	
CHECK:	
DATE:	
APPRO BY:	
CONSULT:	
DATE:	
APPRO BY:	
CITY:	
** IMPORTANT NOTE **	

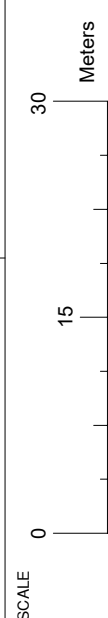

PAGE 2 OF 2	CTNY26039	REVISION 1
TCPO DWG. NO.		CTNY26039
RECORD DWG. NO.		

