


REFERENCE	PARENT	SUB
ROADS		
WATER		
SANITARY		
DRAINAGE		

Legend



Existing Edge of Asphalt	Existing Edge of Gravel
Existing Fence	Existing Top of Slope
Existing Hedge/Treeline	Existing Deciduous/Coniferous/Shrub
W	Prop./Existing Watermain
Prop./Existing Water Service	Prop./Adjusted/Existing Water Valve
Prop./Existing Fire Hydrant	Prop./Existing Water Standpipe
Prop./Existing Curb Stop	Prop./Existing End Cap
S	Prop./Existing Sanitary Sewer
SFM	Prop./Existing Sanitary Foremain
Prop./Adjusted/Existing Sanitary Manhole	Prop./Existing Inspection Chamber
D	Prop./Existing Storm Drainage
DNM	Prop./Existing Storm Foremain
Prop./Existing Storm Service	Prop./Existing Culvert
Prop./Adjusted/Existing Storm Manhole	Prop./Existing Catch Basin
Prop./Existing Side Inlet Catch Basin	Prop./Existing
Gas	Hydro Power
Telephone	Function Box
Hydro/Telephone Manhole	Anchor Wire/Anchor Pole
Hydro/Telephone /Hydro-Tel Pole	Light on Pole/Underground on Pole
Decorative/Deck Light	Parking Meter
Mail Box	Prop./Existing Traffic Sign
Prop./Existing Stop Sign	Monument/Iron Pin/Survey Control

- WATER CC, PWR, TELCO FOUND + SURVEYED
- WATER CC NOT FOUND
- GAS FOUND AND SURVEYED
- NO GAS SERVICE
- WATER SHUT OFFS FOUND 94.23%

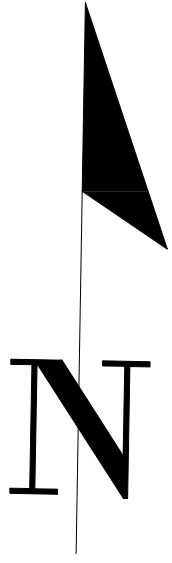

1	LOCATE WATER VALVES AND SURVEY
2	LOCATE WATER VALVES AND SURVEY
1	LOCATE WATER VALVES AND SURVEY

NO.	DATE	DESCRIPTION
REVISIONS & ISSUES		
DESIGN		
DATE	DATE	DATE

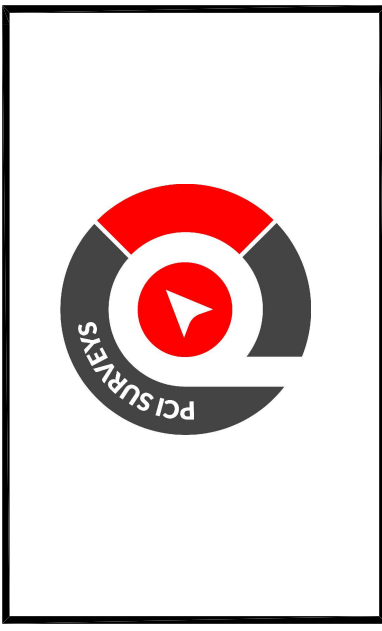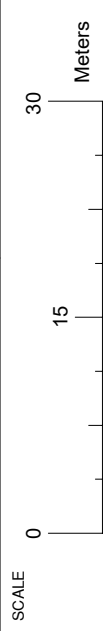

VILLAGE AT SHELLY CREEK
ALL LOCATES
COORDINATE SYSTEM:
NAD83 UTM Zone 10N HT2.0

PAGE	1	OF	2
TOP/DRAWING NO.	CTNY26039		
RECORD DWG. NO.	CTNY26039		
REVISION	1		